
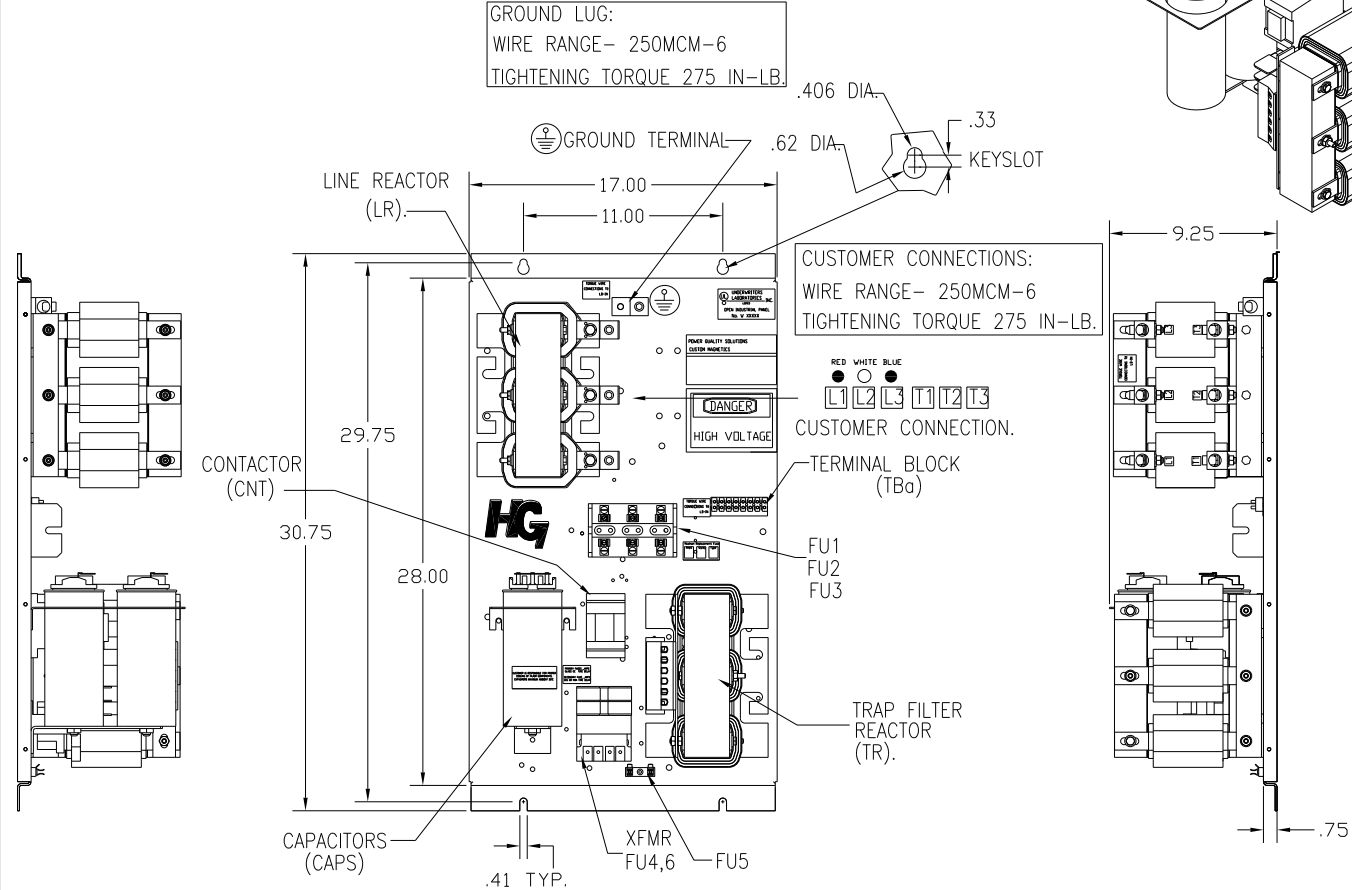


| UNIT SPECIFICATIONS: | | | | | |
|----------------------|----------|------------------|----|-------|-----|
| KW | HARMONIC | VOLT | HZ | PHASE | FLA |
| 45 | 5TH | 400 | 50 | 3 | 90 |
| ENCLOSURE | | WHITE OPEN PANEL | | | |
| APPROX.WT. LBS. | | 143 | | | |

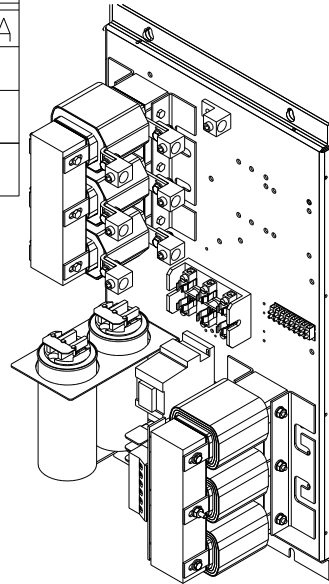

| SYMBOL | TCI PART NUMBER |
|-----------------|-----------------|
| LR | KDRG33T |
| TR | KTR18L55HG |
| CAP1. (15 KVAR) | KCAP15A6B |
| CAP2. (15 KVAR) | KCAP15A6B |
| XFMR. | 24385 |
| Fu1, 2, 3 | 27574 |
| Fu4,6 | 13180 |
| Fu5 | 13364 |
| CNT | 23048 |

CUSTOMER IS RESPONSIBLE FOR PROPER COOLING OF FILTER COMPONENTS. CAPACITORS MAXIMUM AMBIENT 50°C.

CUSTOMER IS RESPONSIBLE FOR INSTALLATION TO MEET ALL NATIONAL AND LOCAL ELECTRICAL CODES.

SEE DRAWING# 27703 FOR SCHEMATIC

| | | | | | |
|-------------|--|-------------------------------|--|---|--|
| | | TOLERANCES (EXCEPT AS NOTED): | | 7878 N. 86th STREET MILWAUKEE, WI 53224 | |
| | | DECIMAL | | HG45LW00STC, 45KW | |
| | | XX ± .03 | | 400/3/50, OPEN, WITH CNT. | |
| | | XXX ± .01 | | DRN. BY DSW DATE 11/04/2010 DWG. NO. 104522DG | |
| | | FRACTIONAL | | SCALE TO FIT | |
| | | ± 1/32 | | APRVD | |
| A AS BUILT | | 11/04/10 | | BY DSW | |
| NO REVISION | | DATE | | BY | |
| | | ± 1/2° | | SHT. 1 OF 1 | |