


UNIT SPECIFICATIONS:					
KW	HARMONIC	VOLT	HZ	PHASE	FLA
55	5TH	400	50	3	105
ENCLOSURE		WHITE OPEN PANEL			
APPROX.WT. LBS.		165			


SYMBOL	TCI PART NUMBER
LR	KDRG34T
TR	KTR22L55HG
CAP1. (20 KVAR)	KCAP20A6B
CAP2. (20 KVAR)	KCAP20A6B
XFMR.	24385
Fu1, 2, 3	11006
Fu4,6	13180
Fu5	13364
CNT	23792

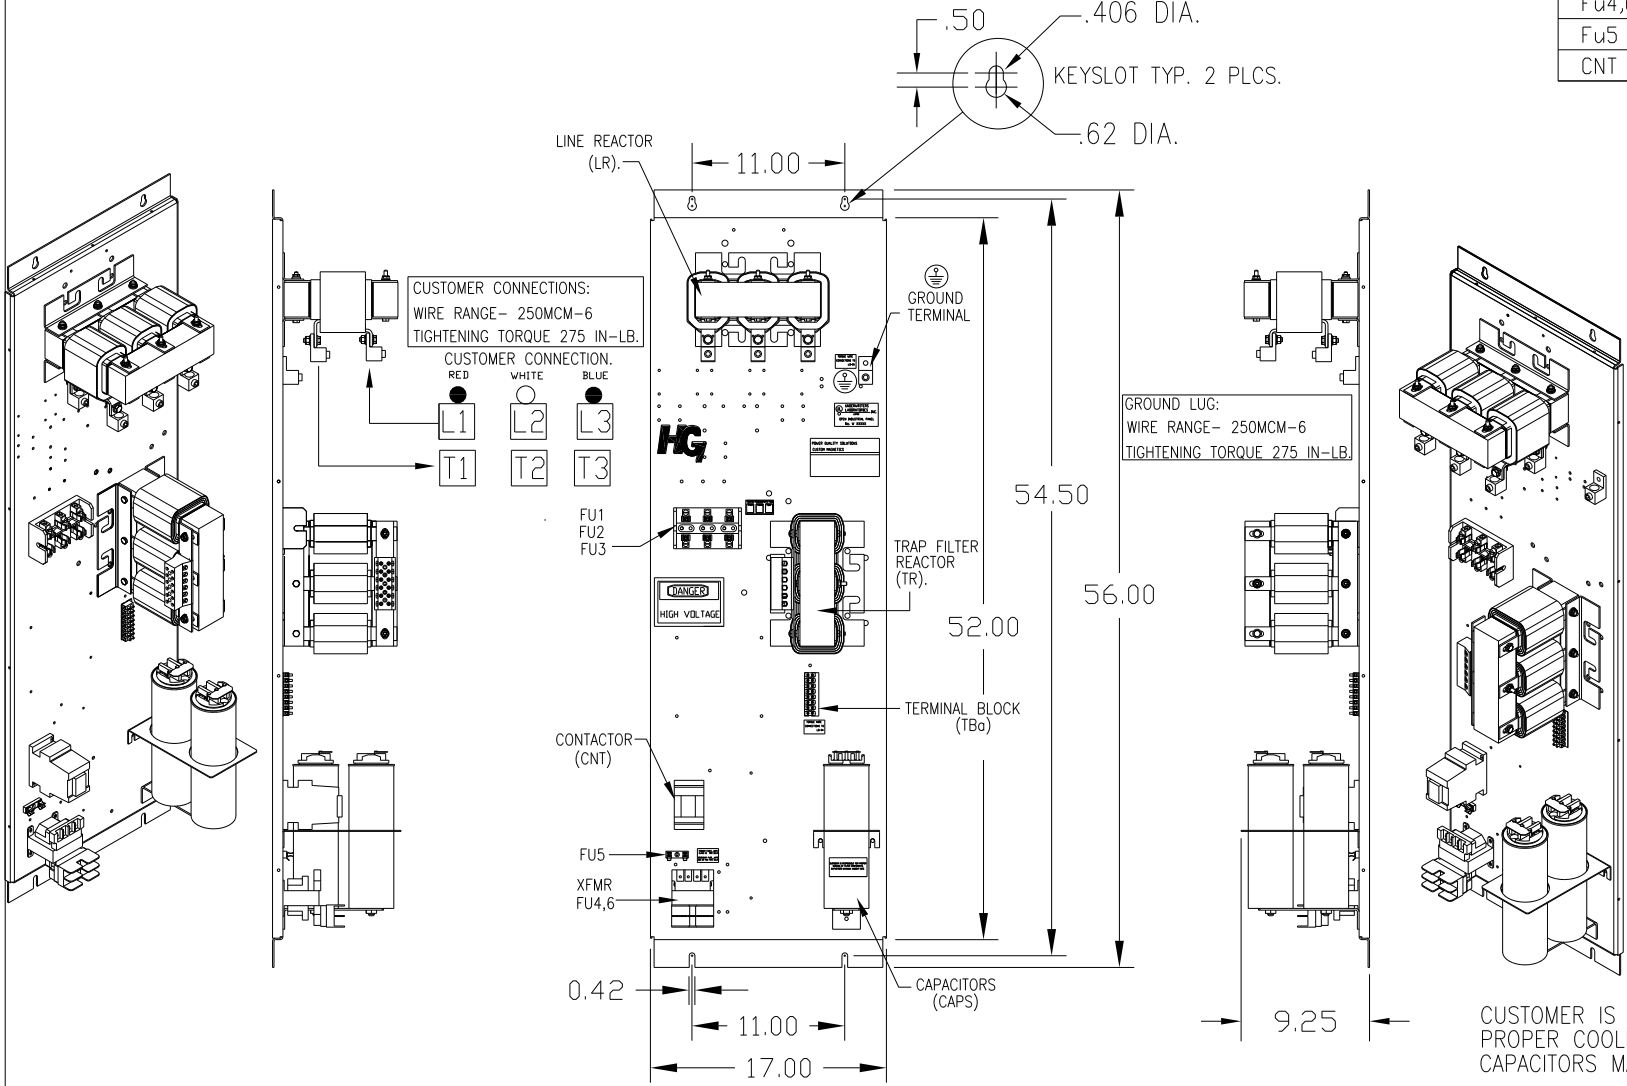

CUSTOMER IS RESPONSIBLE FOR PROPER COOLING OF FILTER COMPONENTS. CAPACITORS MAXIMUM AMBIENT 50°C.

CUSTOMER IS RESPONSIBLE FOR INSTALLATION TO MEET ALL NATIONAL AND LOCAL ELECTRICAL CODES.

SEE DRAWING# 27703 FOR SCHEMATIC

				TOLERANCES (EXCEPT AS NOTED):		 7878 N. 86th STREET MILWAUKEE, WI 53224	
				DECIMAL			
				.XX ± .03		HG55LW00STC, 55KW 400/3/50, OPEN, WITH CNT.	
				.XXX ± .01			
				FRACTIONAL		DRN. BY DSW DATE 11/05/2010 DWG. NO. 104523DG SCALE TO FIT APRV. C	
				± 1/32			
A	AS BUILT	11/04/10	DSW	ANGULAR	± 1/2°		
NO	REVISION	DATE	BY				