


UNIT SPECIFICATIONS:					
KW	HARMONIC	VOLT	HZ	PHASE	FLA
90	5TH	400	50	3	170
ENCLOSURE		WHITE OPEN PANEL			
APPROX.WT. LBS.		250			

SYMBOL	TCI PART NUMBER
LR	KDRL32T
TR	KTR36L55HG
CAP1, 2 (20 KVAR)	KCAP20A6B
CAP3. (15 KVAR)	KCAP15A6B
CAP4. (10 KVAR)	KCAP10A6B
XFMR.	24393
Fu1, 2, 3	24199
Fu4,6	24073
Fu5	24012
CNT	19245

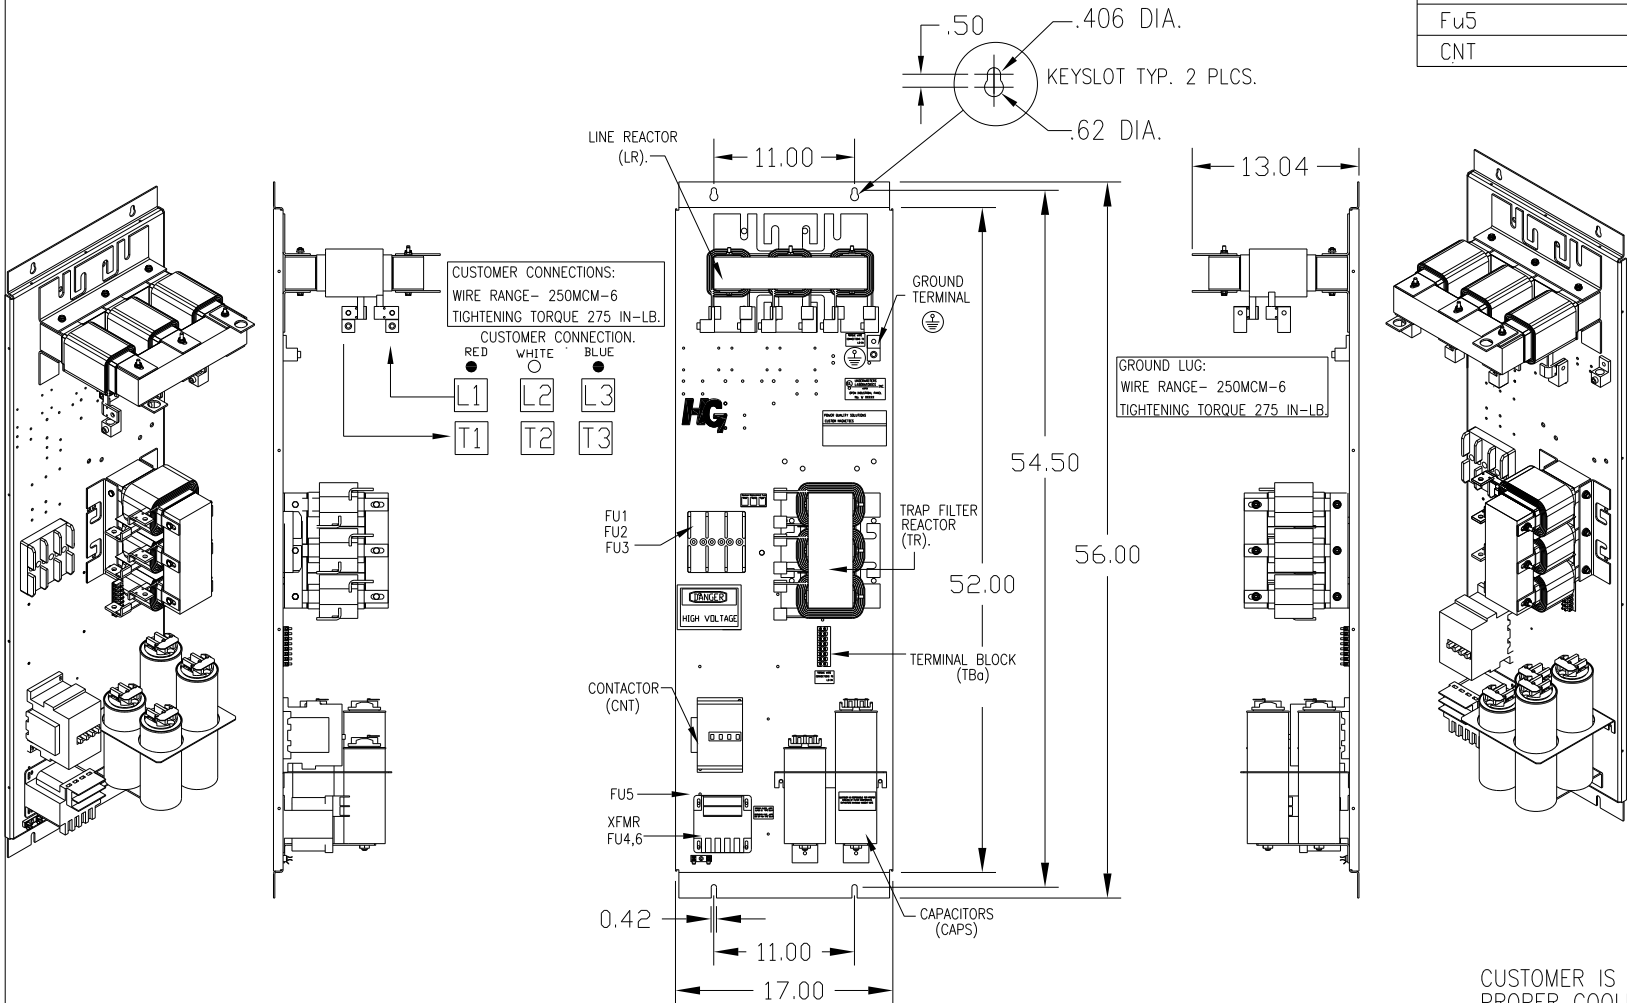

CUSTOMER IS RESPONSIBLE FOR PROPER COOLING OF FILTER COMPONENTS. CAPACITORS MAXIMUM AMBIENT 50°C.

CUSTOMER IS RESPONSIBLE FOR INSTALLATION TO MEET ALL NATIONAL AND LOCAL ELECTRICAL CODES.

SEE DRAWING# 27703 FOR SCHEMATIC

TOLERANCES (EXCEPT AS NOTED)				TCI	
			DECIMAL	7878 N. 86th STREET MILWAUKEE, WI 53224	
			.XX ± .03	HG90LW00STC, 90KW 400/3/50, OPEN, WITH CNT.	
			.XXX ± .01		
			FRACTIONAL ± 1/32		
A	AS BUILT	11/04/10	DSW	DRN. BY DSW	DATE 11/05/2010
NO	REVISION	DATE	BY	ANGULAR ± 1/2°	DWG. NO. 104525DG
				SCALE TO FIT	APRVE. C
				SHT. 1 OF 1	