
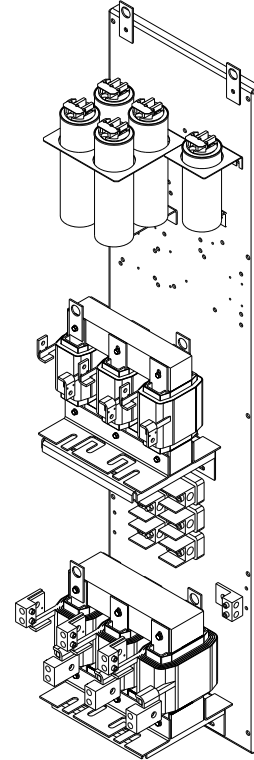


UNIT SPECIFICATIONS:					
KW	HARMONIC	VOLT	HZ	PHASE	FLA
132	5TH	400	50	3	250
ENCLOSURE		WHITE OPEN PANEL			
APPROX.WT. LBS.		335			

SYMBOL	TCI PART NUMBER
LR	KDRS31T
TR	KTR53L55HG
CAP1,2,3,4 (20 KVAR)	KCAP20A6B
CAP5 (15 KVAR)	KCAP15A6B
Fu1, 2, 3	11170

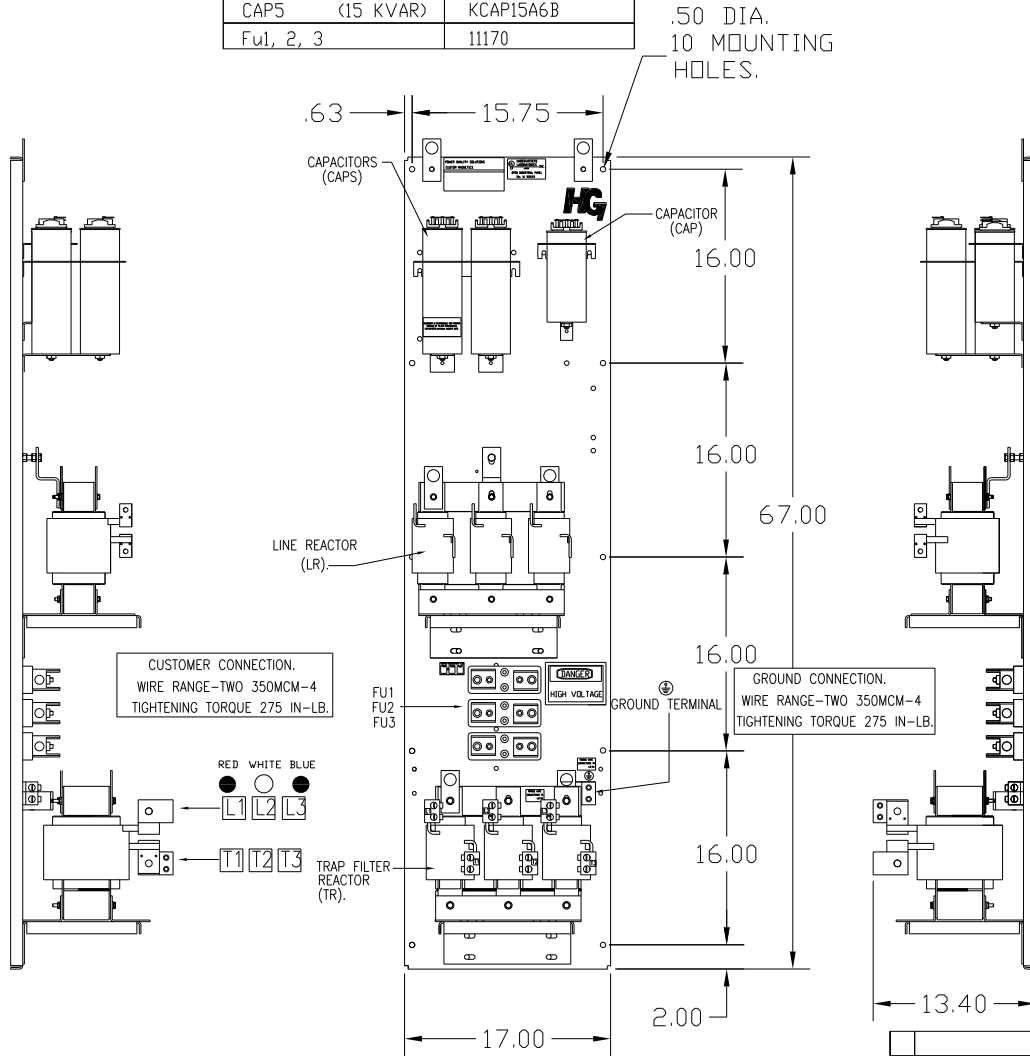

CUSTOMER CONNECTION.
WIRE RANGE-TWO 350MCM-4
TIGHTENING TORQUE 275 IN-LB.

GROUND CONNECTION.
WIRE RANGE-TWO 350MCM-4
TIGHTENING TORQUE 275 IN-LB.

CUSTOMER IS RESPONSIBLE FOR PROPER COOLING OF FILTER COMPONENTS. CAPACITORS MAXIMUM AMBIENT 50°C.

CUSTOMER IS RESPONSIBLE FOR INSTALLATION TO MEET ALL NATIONAL AND LOCAL ELECTRICAL CODES.

SEE DRAWING# 27709 FOR SCHEMATIC

TOLERANCES (EXCEPT AS NOTED)		TOLERANCES (EXCEPT AS NOTED)		TOLERANCES (EXCEPT AS NOTED)	
	DECIMAL		DECIMAL		DECIMAL
	XX ± .03		XX ± .03		XX ± .03
	XXX ± .01		XXX ± .01		XXX ± .01
	FRACTIONAL		FRACTIONAL		FRACTIONAL
	± 1/32		± 1/32		± 1/32
	ANGULAR		ANGULAR		ANGULAR
	± 1/2°		± 1/2°		± 1/2°
A	AS BUILT	11/04/10	DSW	DATE	BY
NO	REVISION	DATE	BY	DATE	BY

7878 N. 86th STREET
MILWAUKEE, WI 53224

HG132LW00ST, 132KW
400/3/50, OPEN.

DRN. BY DSW DATE 11/16/2010 DWG. NO. 104505DG
SCALE TO FIT APRVD C

SHT. 1 OF 1