


UNIT SPECIFICATIONS:					
KW	HARMONIC	VOLT	HZ	PHASE	FLA
9.3	5TH	400	50	3	20
ENCLOSURE		WHITE OPEN PANEL			
APPROX.WT. LBS.		46			

SYMBOL	TCI PART NUMBER
LR	KDRE32T
TR	KTR3L55HG
CAP, 2.. (3 KVAR)	KCAP3A6A
Fu1, 2, 3	22923

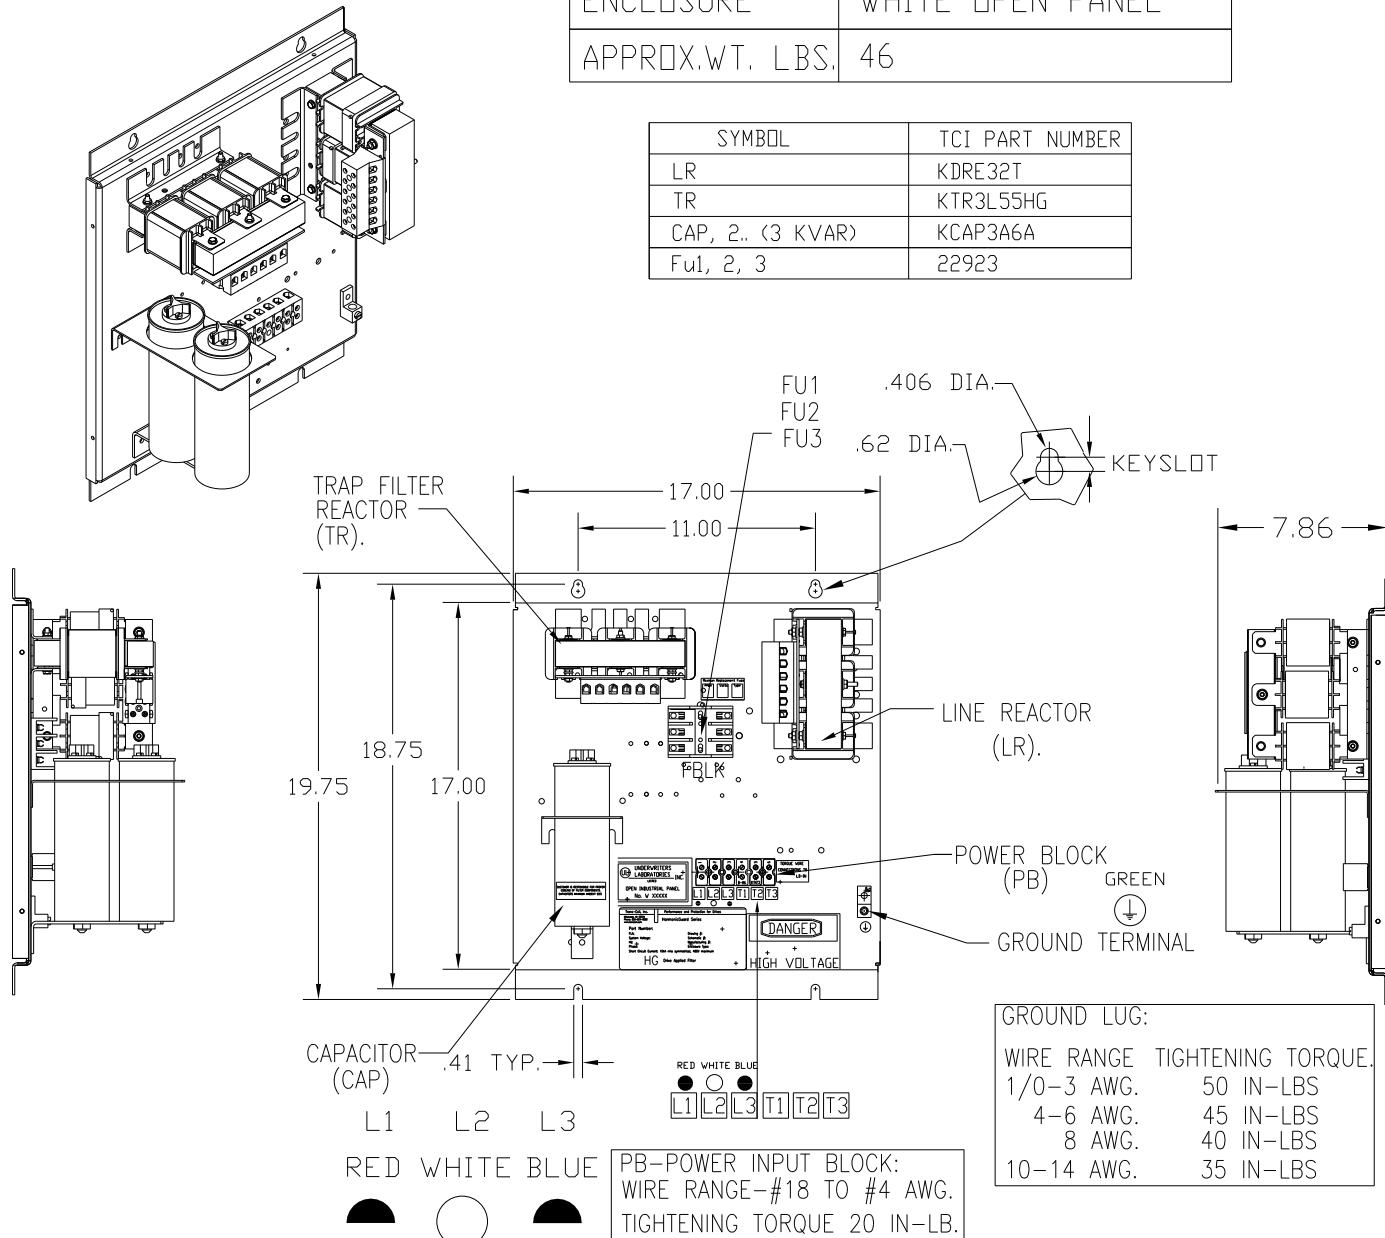

CUSTOMER IS RESPONSIBLE FOR PROPER COOLING OF FILTER COMPONENTS. CAPACITORS MAXIMUM AMBIENT 50°C.

CUSTOMER IS RESPONSIBLE FOR INSTALLATION TO MEET ALL NATIONAL AND LOCAL ELECTRICAL CODES.

TOLERANCES (EXCEPT AS NOTED)				7878 N. 86th STREET MILWAUKEE, WI 53224	
			DECIMAL		
			XX ± .03		
			XXX ± .01		
			FRACTIONAL	HG9LW00ST, 9.3KW 400/3/50, OPEN	
			± 1/32		
A	AS BUILT	5/10/11	DSW	DRN. BY	DATE
NO	REVISION	DATE	BY	APPRVD	DWG. NO.
			ANGULAR	SCALE	TO FIT
			± 1/2°		
					104661DG SHT. 1 OF 1