


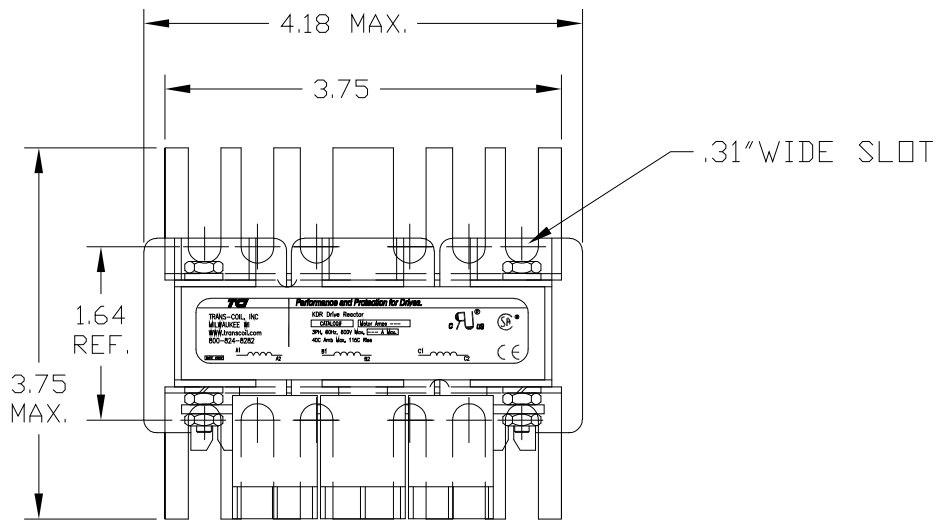

CATALOG NO	AMPS	VOLTS(V)	--mH ^{+5%} ₋₀	APPROX WT-LBS	TERMINAL BLOCK TORQUE (LB-IN)
KTR09A65HG	1.67	34.56	31.8	4	10

TCI
TRANS-COIL, INC
MILWAUKEE WI
WWW.transcoil.com
800-824-8282




PERFORMANCE AND PROTECTION FOR DRIVES.
KDR Drive Reactor
CATALOG#
MOTOR HP AMPS
3PH, 60Hz, 600V Max, --- A Max.
40C Amb Max, 115C Rise

CE


DATE CODE

A1 A2 B1 B2 C1 C2

NOTE: DESCRIPTION

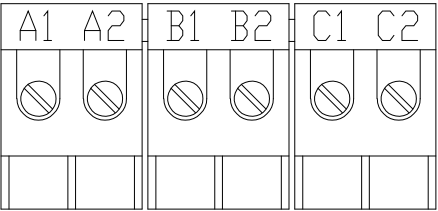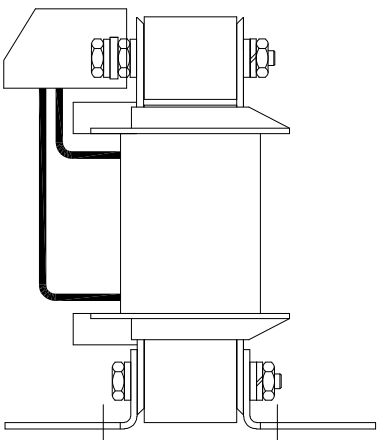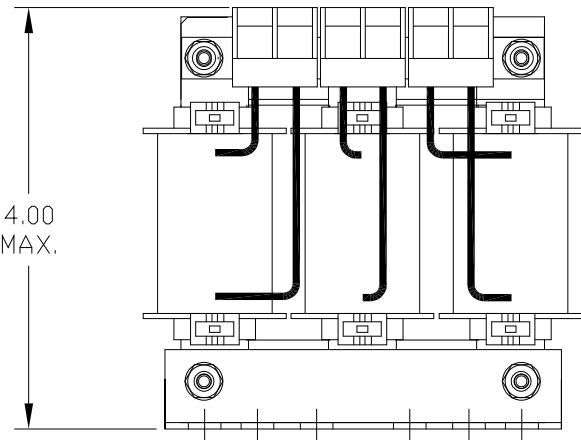

NOTE: A1, A2, B1, B2, C1, C2,
MARKINGS TERMINAL BLOCK
FOR REFERENCE ONLY.

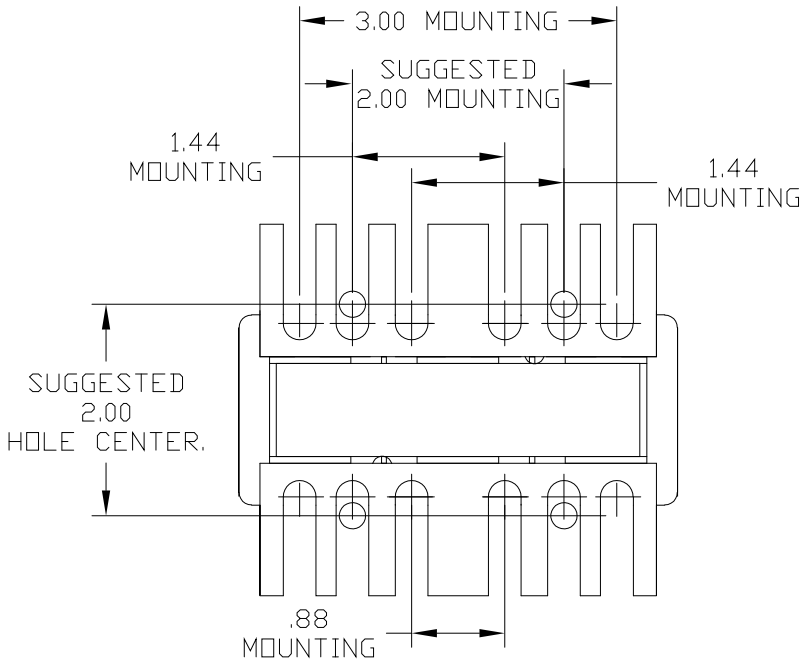

				TOLERANCES (EXCEPT AS NOTED)		 W132 N10611 Grant Drive Germantown, WI 53022		
				DECIMAL				
				.XX ± .03		KTR09A65HG 3 HP, 1.67 AMPS, 480V		
				.XXX± .01				
				FRACTIONAL ± 1/32		DRN. BY DSW DATE 3/12/13 DWG. NO. B 105233DG		
				ANGULAR ± 1/2°				
AS BUILT		3/12/13	DSW			SCALE TO FIT		APRVD.
NO	REVISION	DATE	BY			SHT. 1 of 1		