UNIT SPECIFICATIONS:					
KW	HARMONIC	VOLT	HZ	PHASE	FLA
160	5TH	400	50	3	320
ENCLOSURE	WHITE OPEN PANEL				
APPROX.WT. LBS.	645				

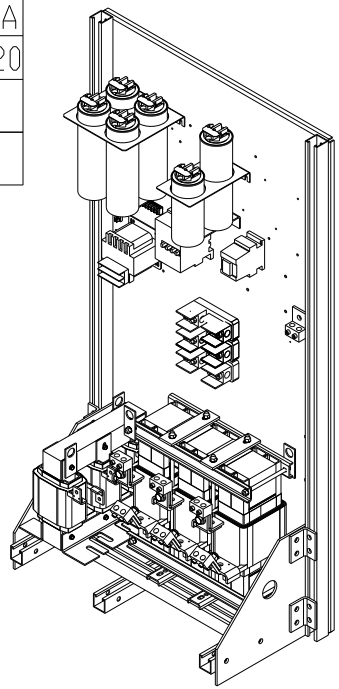

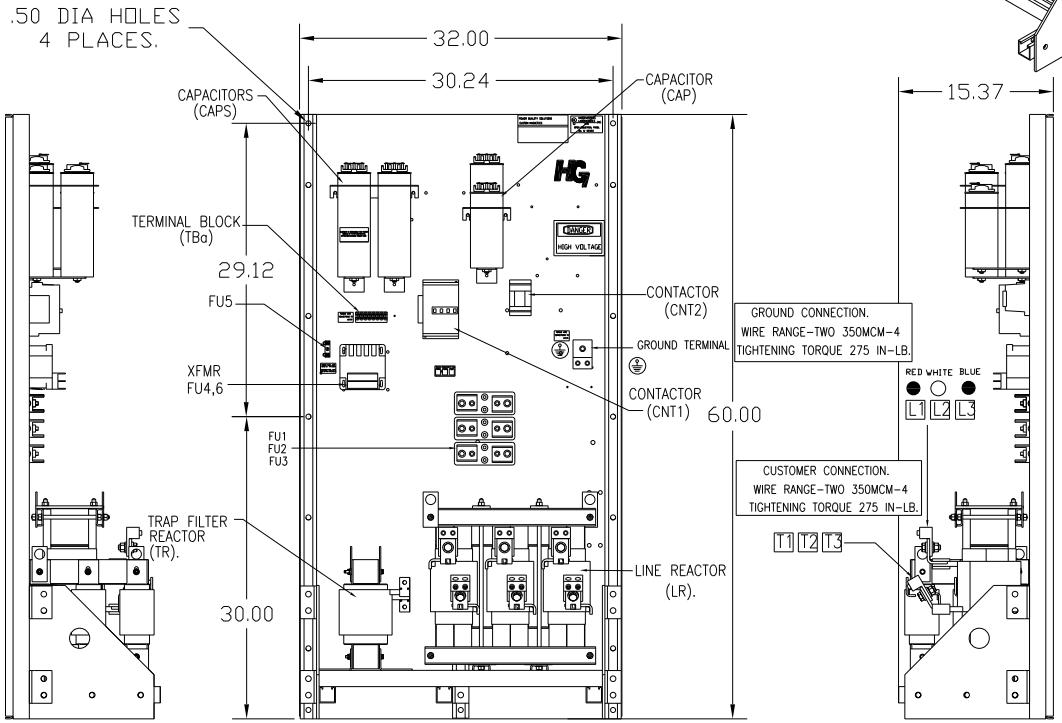

SYMBOL	TCI PART NUMBER
LR	KDRX31T
TR	KTR64L55HG
CAP1,2,3,4,5 (20 KVAR)	KCAP20A6B
CAP6 (10 KVAR)	KCAP10A6B
XFMR.	24393
Fu1, 2, 3	11170
Fu4,6	24073
Fu5	24012
CNT1	19245
CNT2	23048

CUSTOMER IS RESPONSIBLE FOR
PROPER COOLING OF FILTER COMPONENTS.
CAPACITORS MAXIMUM AMBIENT 50°C.

CUSTOMER IS RESPONSIBLE FOR INSTALLATION
TO MEET ALL NATIONAL AND LOCAL ELECTRICAL CODES.

SEE DRAWING# 27703 FOR SCHEMATIC

NO	REVISION	DATE	BY
A	AS BUILT	11/04/10	DSW

TOLERANCES (EXCEPT AS NOTED)
DECIMAL .XX ± .03 .XXX± .01
FRACTIONAL ± 1/32
ANGULAR ± 1/2°

TCI 7878 N. 86th STREET MILWAUKEE, WI 53224

HG160LW00STC, 160KW
400/3/50, OPEN, WITH CNT.

DRN. BY DSW | DATE 11/04/2010 | DWG. NO. C 104528DG
SCALE TO FIT | APRVD. | SHT. 1 OF 1